


# WATER IRRIGATION STORM DRAIN SEWER

# DRAFT

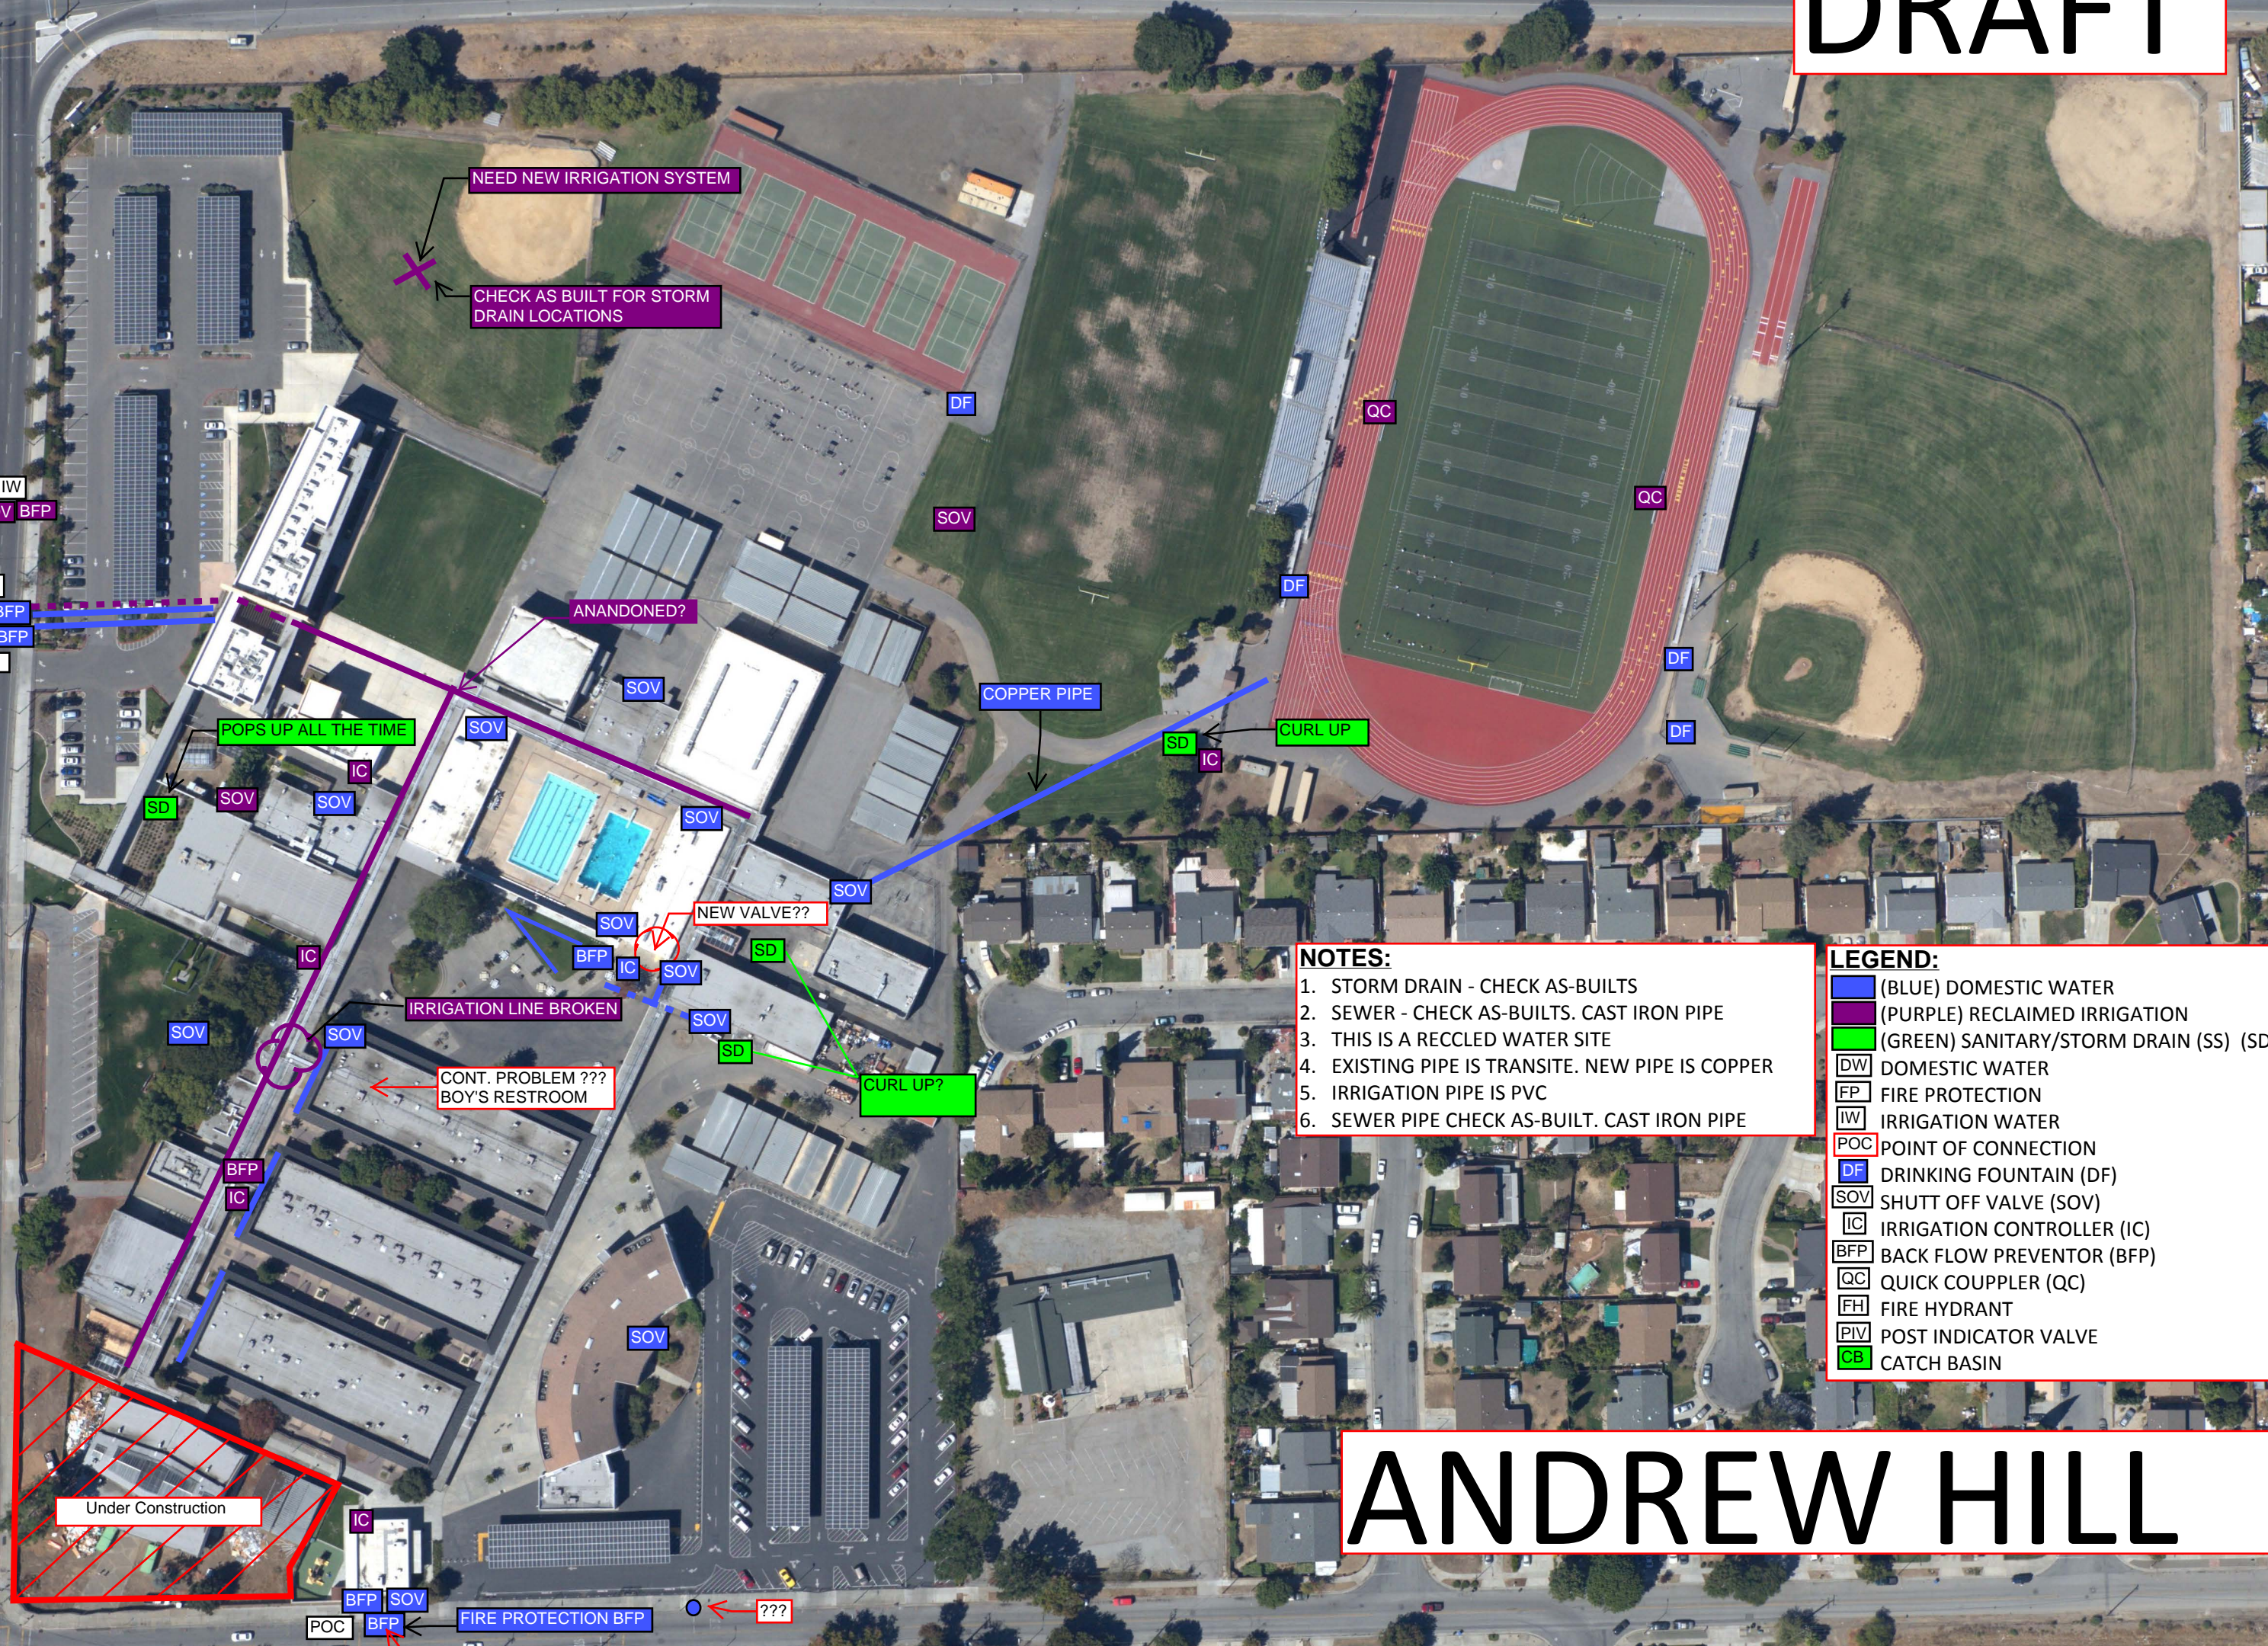

- NOTES:**
1. STORM DRAIN - CHECK AS-BUILTS
  2. SEWER - CHECK AS-BUILTS. CAST IRON PIPE
  3. THIS IS A RECCLED WATER SITE
  4. EXISTING PIPE IS TRANSITE. NEW PIPE IS COPPER
  5. IRRIGATION PIPE IS PVC
  6. SEWER PIPE CHECK AS-BUILT. CAST IRON PIPE

**LEGEND:**

(BLUE)	DOMESTIC WATER
(PURPLE)	RECLAIMED IRRIGATION
(GREEN)	SANITARY/STORM DRAIN (SS) (SD)
DW	DOMESTIC WATER
FP	FIRE PROTECTION
IW	IRRIGATION WATER
POC	POINT OF CONNECTION
DF	DRINKING FOUNTAIN (DF)
SOV	SHUTT OFF VALVE (SOV)
IC	IRRIGATION CONTROLLER (IC)
BFP	BACK FLOW PREVENTOR (BFP)
QC	QUICK COUPLER (QC)
FH	FIRE HYDRANT
PIV	POST INDICATOR VALVE
CB	CATCH BASIN

# ANDREW HILL

NEED NEW IRRIGATION SYSTEM

CHECK AS BUILT FOR STORM DRAIN LOCATIONS

POPS UP ALL THE TIME

ANANDONED?

COPPER PIPE

CURL UP

NEW VALVE??

IRRIGATION LINE BROKEN

CONT. PROBLEM ??? BOY'S RESTROOM

CURL UP?

Under Construction

FIRE PROTECTION BFP

???

???